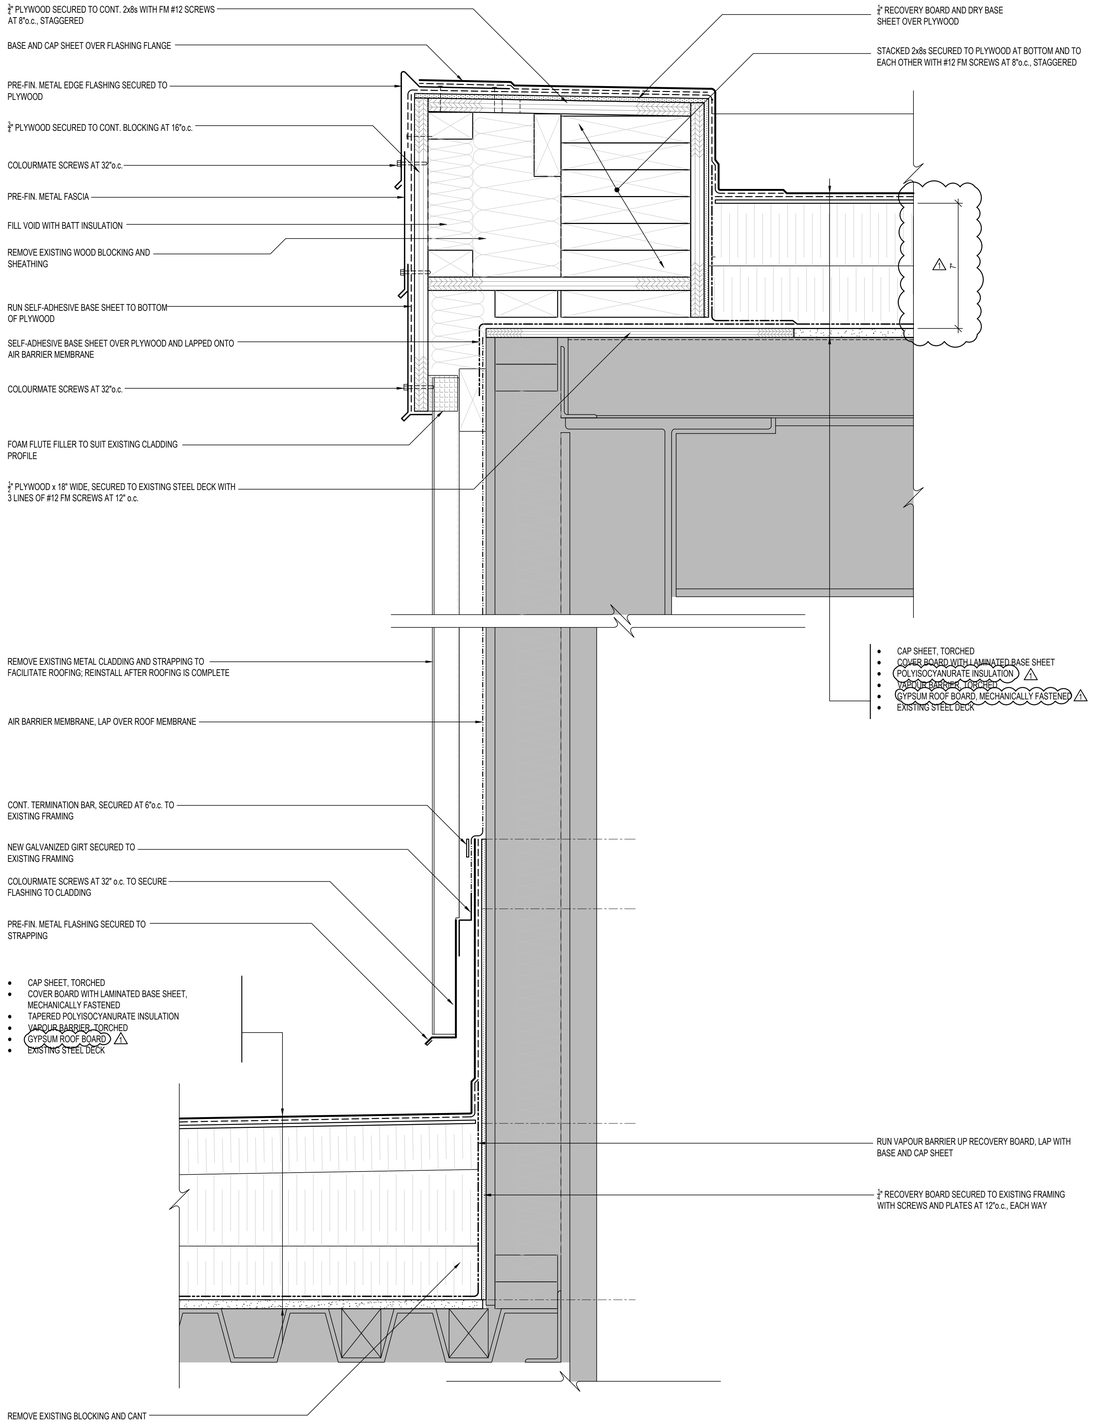

1 ROOF D TO METAL CLADDING WALL AT ROOF B RAKE

SCALE: 3" = 1'-0"

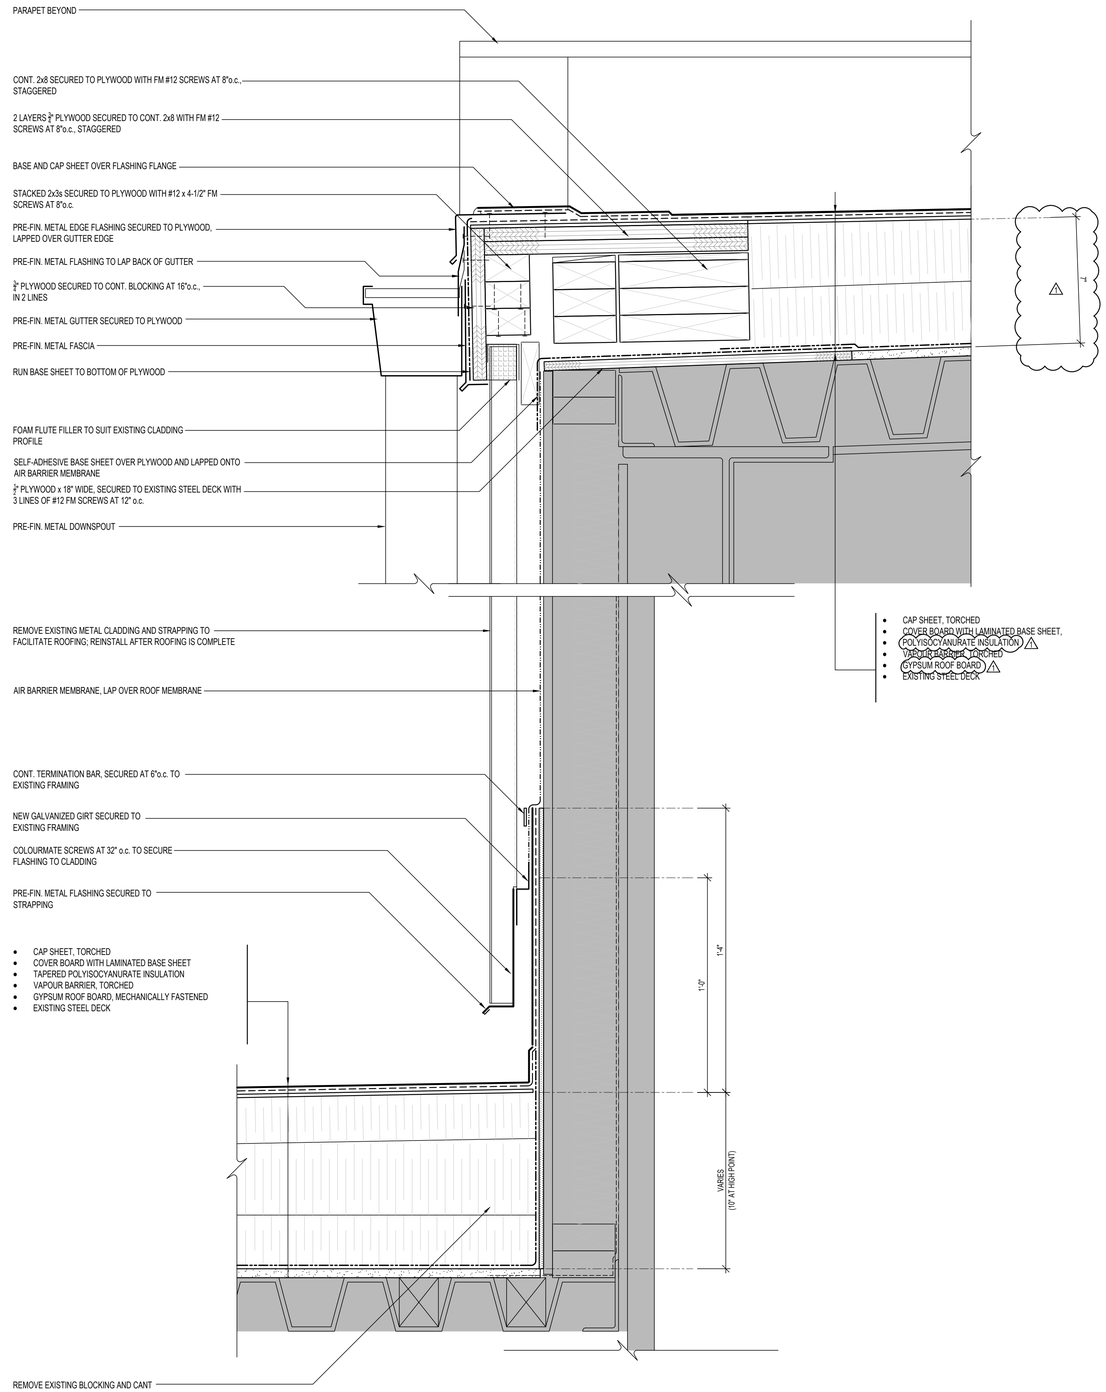

2 ROOF D TO METAL CLADDING WALL AT ROOF B EAVE

SCALE: 3" = 1'-0"

Halifax Regional Centre for Education

KEY PLAN

LOGO

FBM ARCHITECTURE • INTERIOR DESIGN

HS1-1660 Hollis Street
Halifax, Nova Scotia B3J 1V7
Canada

T: (902) 429-4100
architects@fbm.ca
fbm.ca

GRAPHIC SCALE

DATE	MARK	ISSUE
01OCT2024	1	ISSUED FOR ADDENDUM 01
23SEP2024	0	ISSUED FOR TENDER

STAMP

SCALE:	AS NOTED
DRAWN BY:	SED
CHECKED BY:	SED
REVIEWED BY:	
APPROVED BY:	
AS-BUILT CHECK	
DATE:	

PROJECT

HAMMONDS PLAINS ELEMENTARY SCHOOL ROOF REPLACEMENT PHASE 3

HALIFAX, NOVA SCOTIA

PROJECT NO.: 2024-014

SHEET TITLE

DETAILS

INTERNAL NO.:

A-502

SHEET OF

TPW A1 REV OC13 2023